


**CEILING CONFIGURATION**  
 Reflected Plan  
 Highlight Windows shown in RED

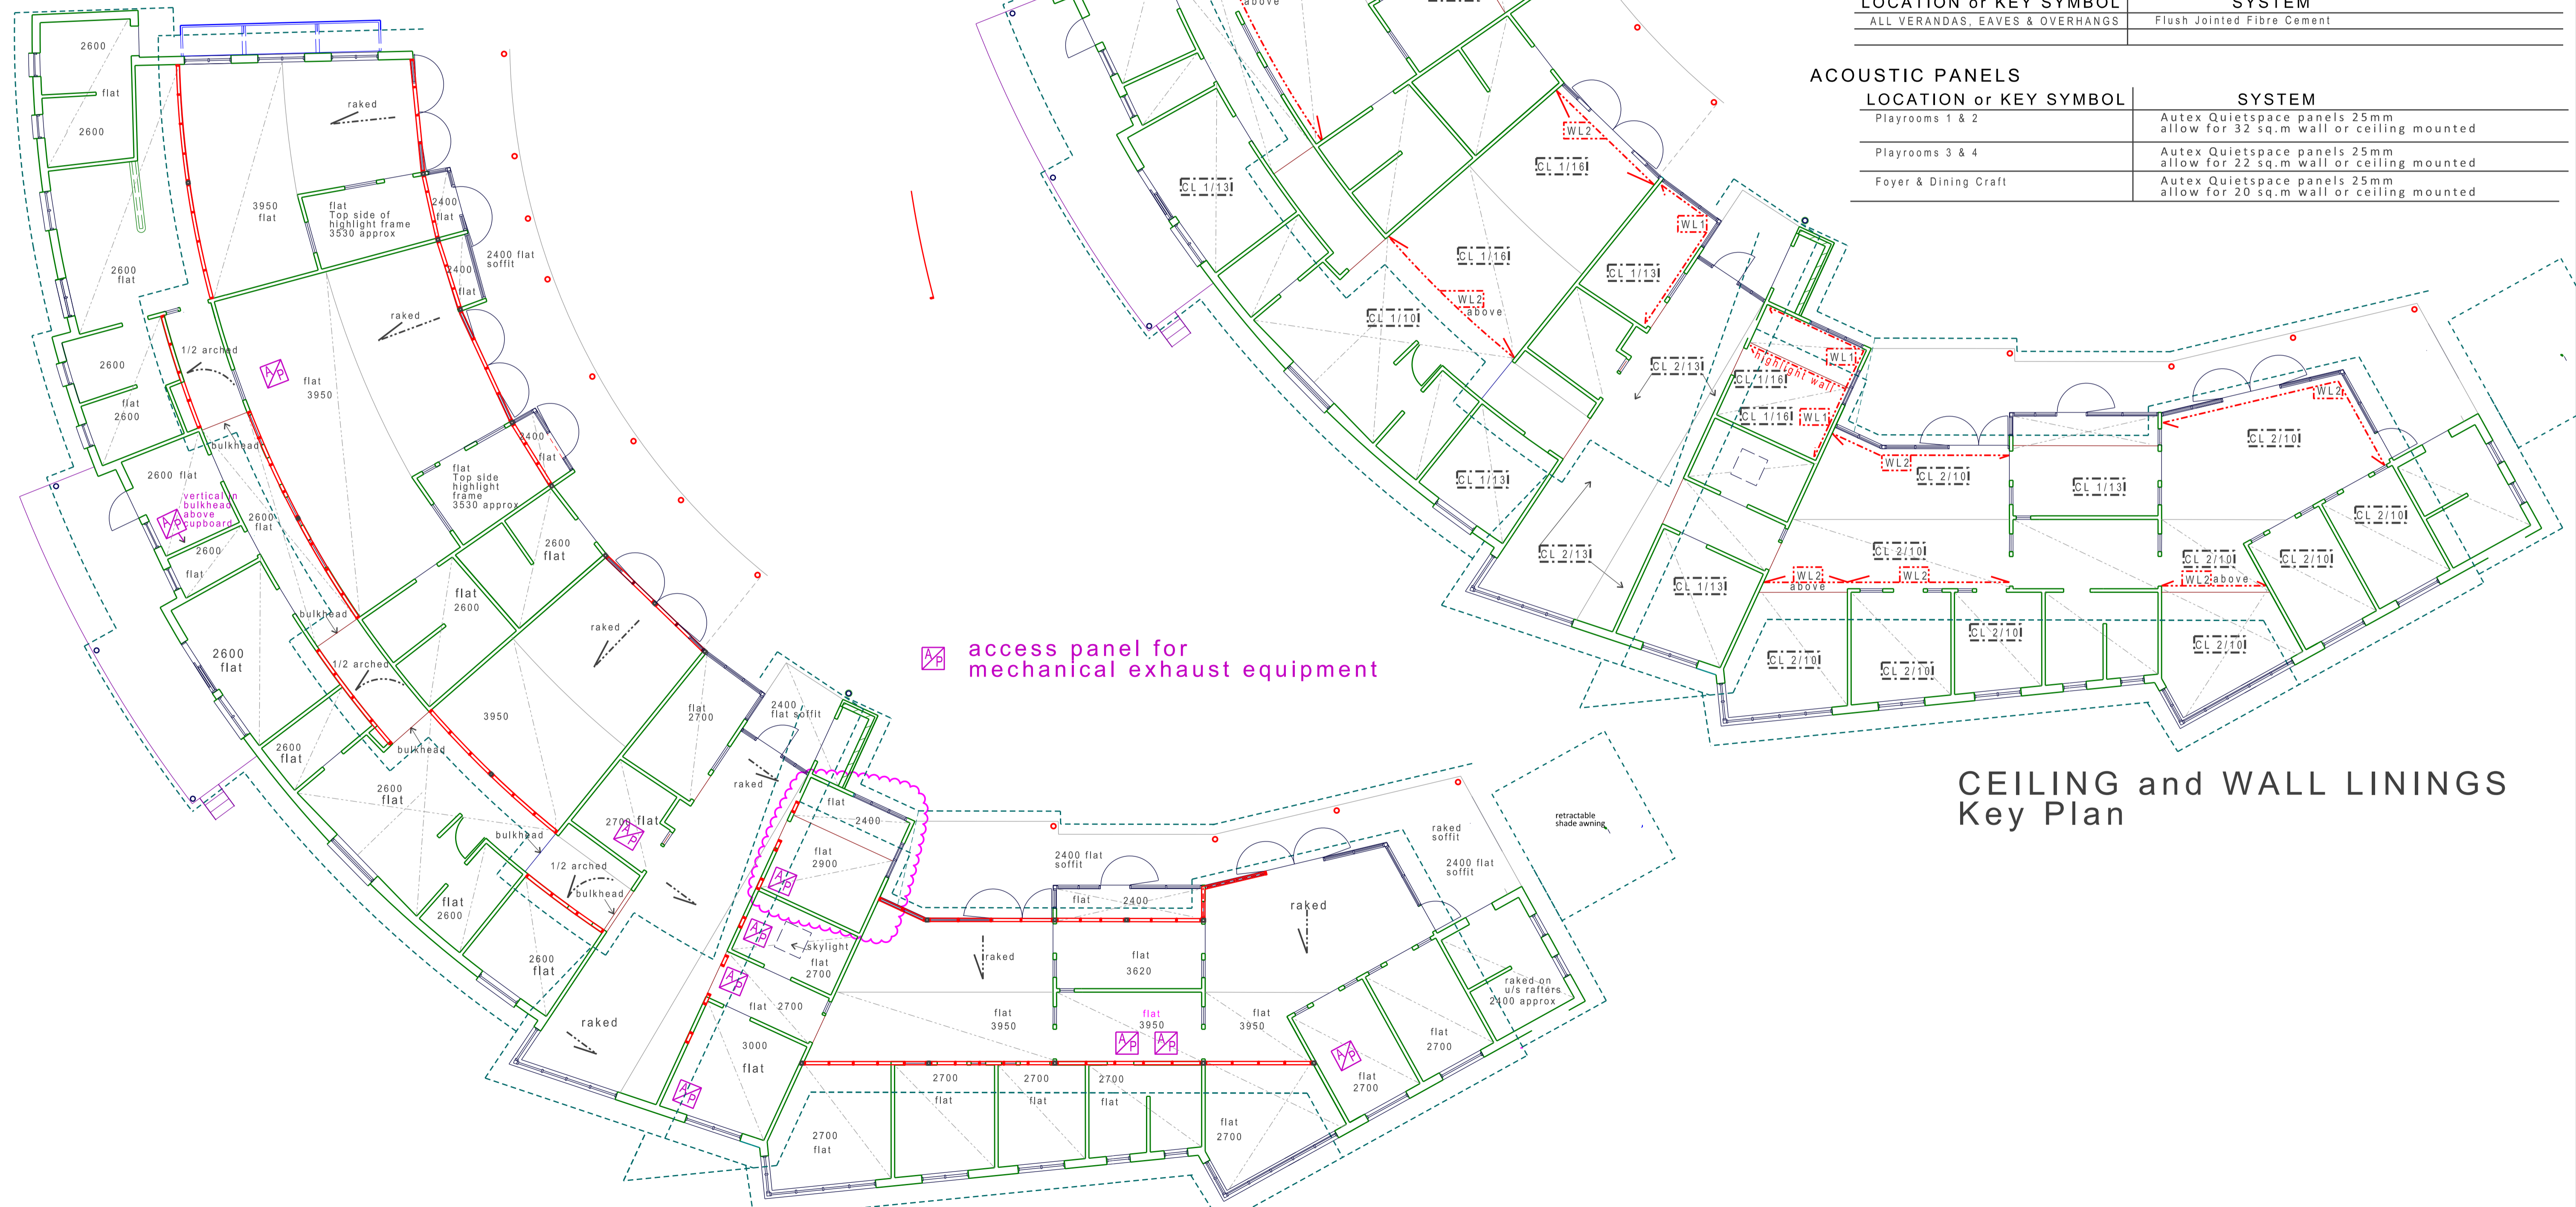

**LININGS KEY**

**WALLS**

LOCATION or KEY SYMBOL	SYSTEM
GENERALLY EXCEPT WHERE NOTED	13mm *Impactchek to 1200 afl; 13mm plasterboard above
WL1	2 layers of 16mm plasterboard
WL2	2x13mm plasterboard system; 13 Impactchek face sheet to 1200 afl; 2 x13mm plasterboard above
WASHROOMS, LAUNDRY and WCs KITCHEN	6mm fibre cement

**CEILING**

LOCATION or KEY SYMBOL	SYSTEM
GENERALLY EXCEPT WHERE NOTED	1 layer of 10mm plasterboard
CL 2/10	2 layers of 10mm plasterboard
CL 2/13	2 layers of 13mm plasterboard
CL 1/16	1 layers of 16mm plasterboard
CL 1/13	1 layer of 13mm plasterboard

**SOFFITS**

LOCATION or KEY SYMBOL	SYSTEM
ALL VERANDAS, EAVES & OVERHANGS	Flush Jointed Fibre Cement

**ACOUSTIC PANELS**

LOCATION or KEY SYMBOL	SYSTEM
Playrooms 1 & 2	Autex Quietspace panels 25mm allow for 32 sq.m wall or ceiling mounted
Playrooms 3 & 4	Autex Quietspace panels 25mm allow for 22 sq.m wall or ceiling mounted
Foyer & Dining Craft	Autex Quietspace panels 25mm allow for 20 sq.m wall or ceiling mounted

access panel for mechanical exhaust equipment

**CEILING and WALL LININGS**  
 Key Plan



**Dillon & Savage Architects**  
 40 Quinton Rd, Manly, 2095  
 Phone: (02) 9977 3714 Fax: (02) 9977 8215  
 email: dsarchs@bigpond.net.au

Client  
**LEICHHARDT COUNCIL**

Project  
 Proposed Child Care Centre  
 Leichhardt Park

Drawing  
**REFLECTED CEILING PLAN & LININGS SCHEDULE**

Date	Amendment
G 09/16	Staff Programming Ceiling amended and highlight windows deleted
F 13/5/16	Kitchen ceiling amended to 10mm plasterboard
E 12/5/16	Ceiling heights amended to match section
D 28/4/16	Additional highlight window added Directors office/condor
C 16/7/15	CONSTRUCTION ISSUE
B 19/4/15	Issued for tender
A 23/3/15	Issued for pre-tender estimate

Drawing No. **103 131 TD10**

Issue **G** Date **March 2015**

Scale **1:100** Drawn Checked